



**Environmental Health Section
Alamance County Health Department
(336) 570-6367**

Name: BACKWOODS LAND LLC Tax Map #: 11-8-7A
 Subdivision: Lot#: 2
 IP: X AWC: OP: WELL: X
 EHS: RES Date: 3/2/2022

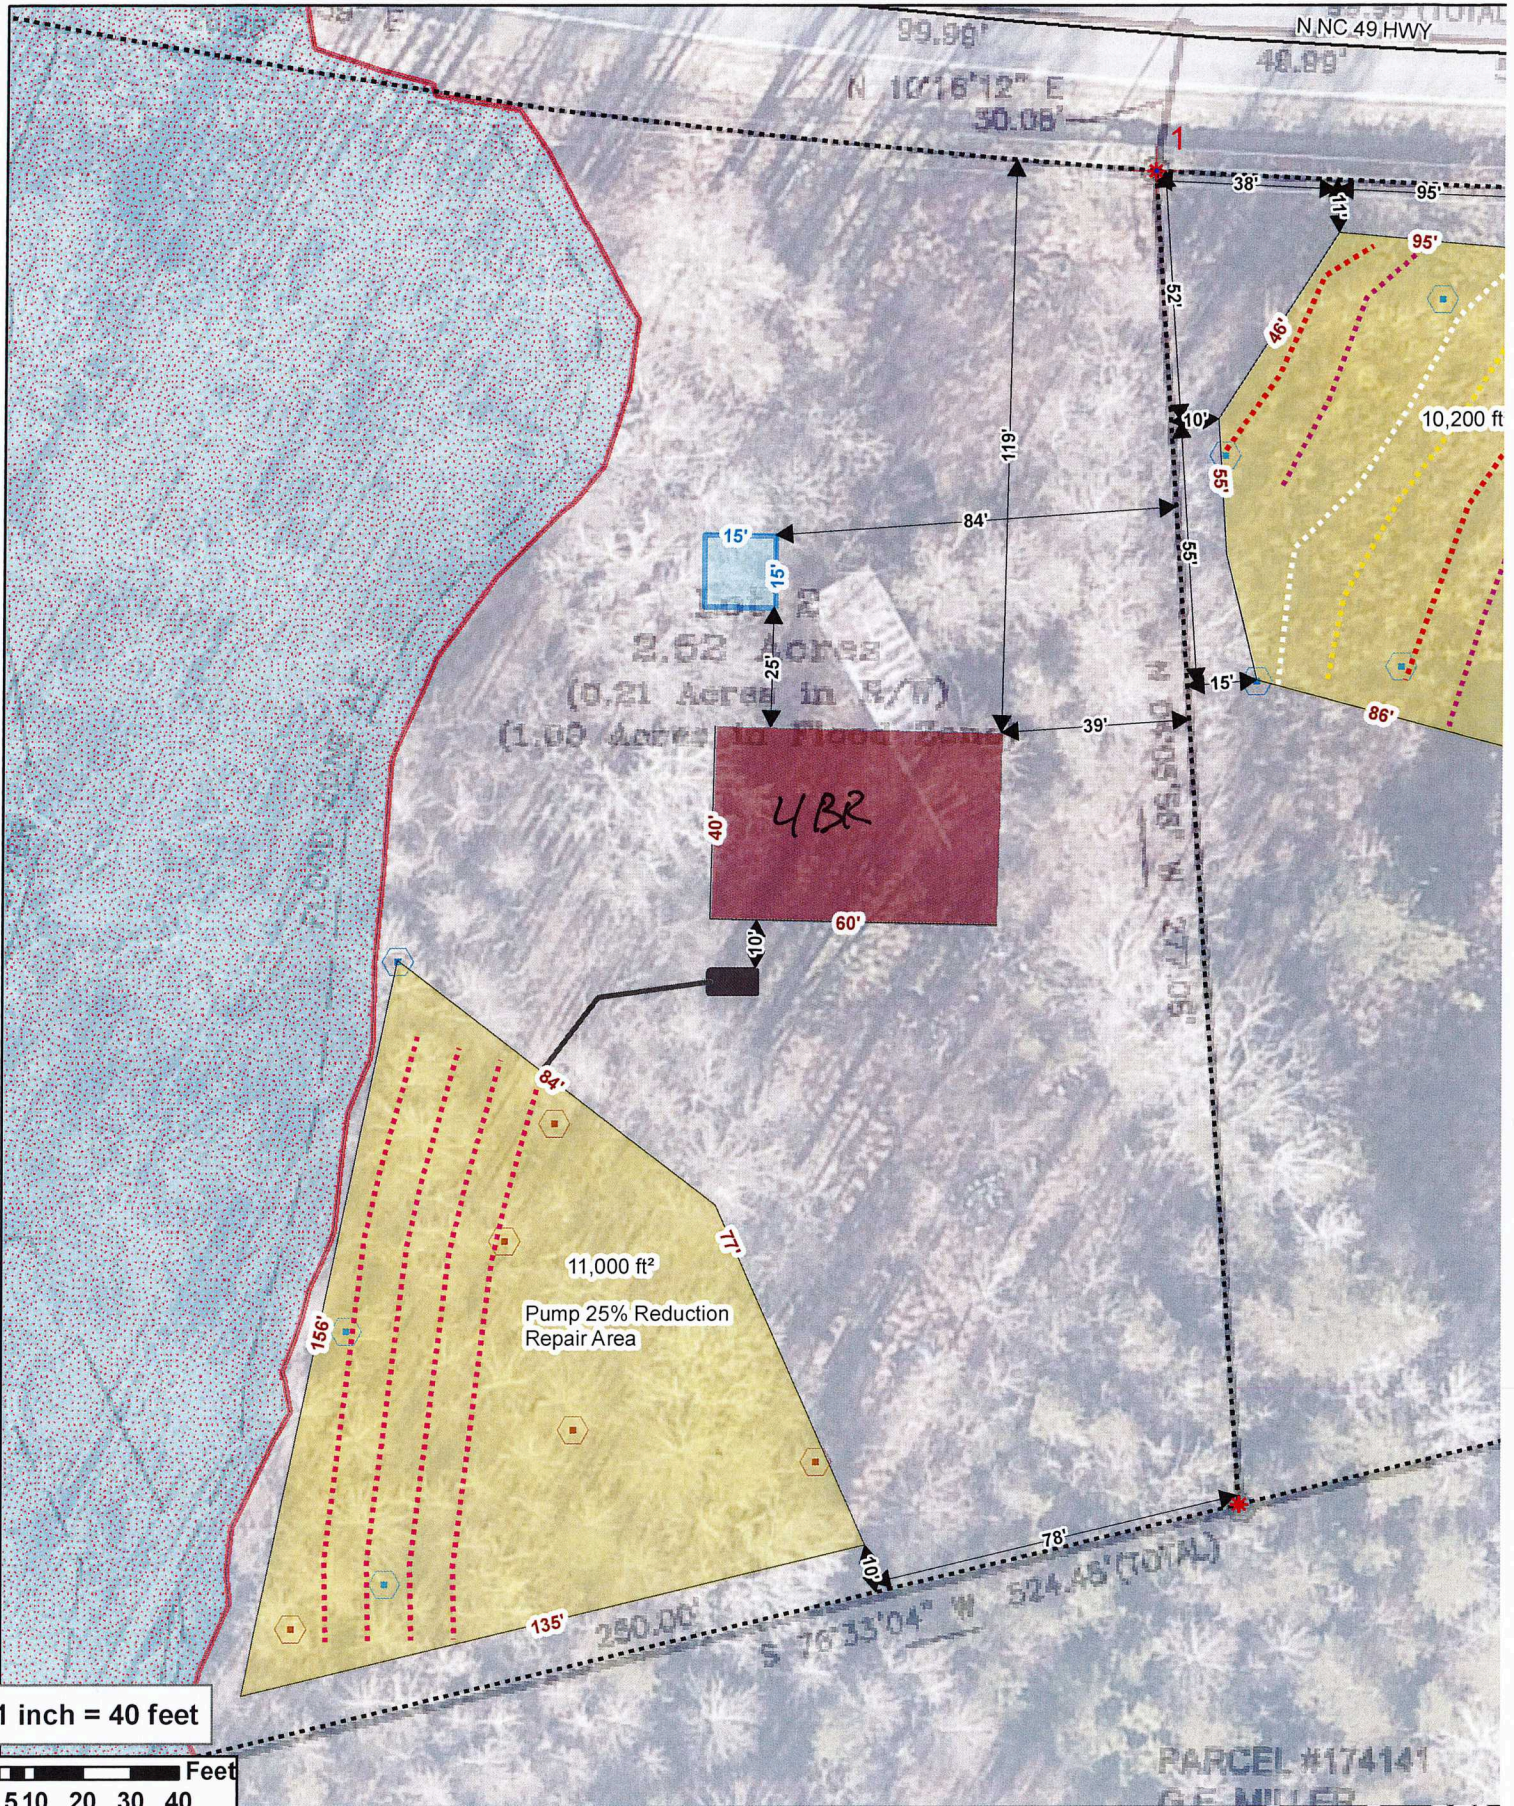

1 inch = 40 feet

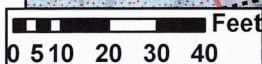

Scale is approximate and may not be accurate on emailed, scanned, and faxed copies of this drawing.

This Map is the best representation of field data based on information supplied to ACHD and is accurate within the limits of our equipment.

Drawn By: RES

Date Printed: 3/1/2022