


**CASWELL COUNTY ENVIRONMENTAL HEALTH**  
**144 MAIN STREET, P.O. BOX 1406, YANCEYVILLE, NC 27379/ (336) 694-9731, FAX (336) 694-5547**  
**IMPROVEMENT PERMIT**

<b>ISSUED TO:</b>	TOMMY DIXON	<b>PIN</b>	0048 016	<b>PERMIT NUMBER:</b>	3675
-------------------	-------------	------------	----------	-----------------------	------

**Section I: Improvement Permit (A Building Permit Cannot Be Issued With Only An Improvement Permit)**

IP		Property Location:	LOT 9 WILSON RD
Type of Structure: SFD			
Number of Bedrooms:	04	Basement: NO	Pump Required: NO
Number of Occupants:	8	Pump May Be Required Based Upon Final Location and Elevations of Facilities.	
Type of Water Supply:	Private well	Water Shed:	
Projected Daily Flow (GPD):	480gpd	<i>Permit Valid For: Five Years</i>	
Type of Wastewater System:	IIIG		
Site Improvements Required Prior To Construction Authorization Issuance:			
Permit Conditions:			

Authorized State Agent:

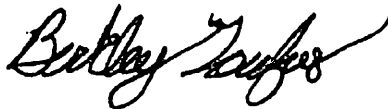

Date: 09/24/2024

**SEE ATTACHED SITE SKETCH**


**The issuance of this permit by the Health Department in no way guarantees the issuance of other permits. The permit holder is responsible for checking with appropriate governing bodies in meeting their requirements. This permit is subject to revocation if the site plan, plat, or the intended use changes. The Improvement Permit shall not be affected by a change in ownership of the site. This permit is subject to compliance with the provisions of the Laws and Rules for Sewage Treatment and Disposal and to conditions of this permit.**



Name: Tommy Dixon

PIN: 0048 016

Permit: 3675

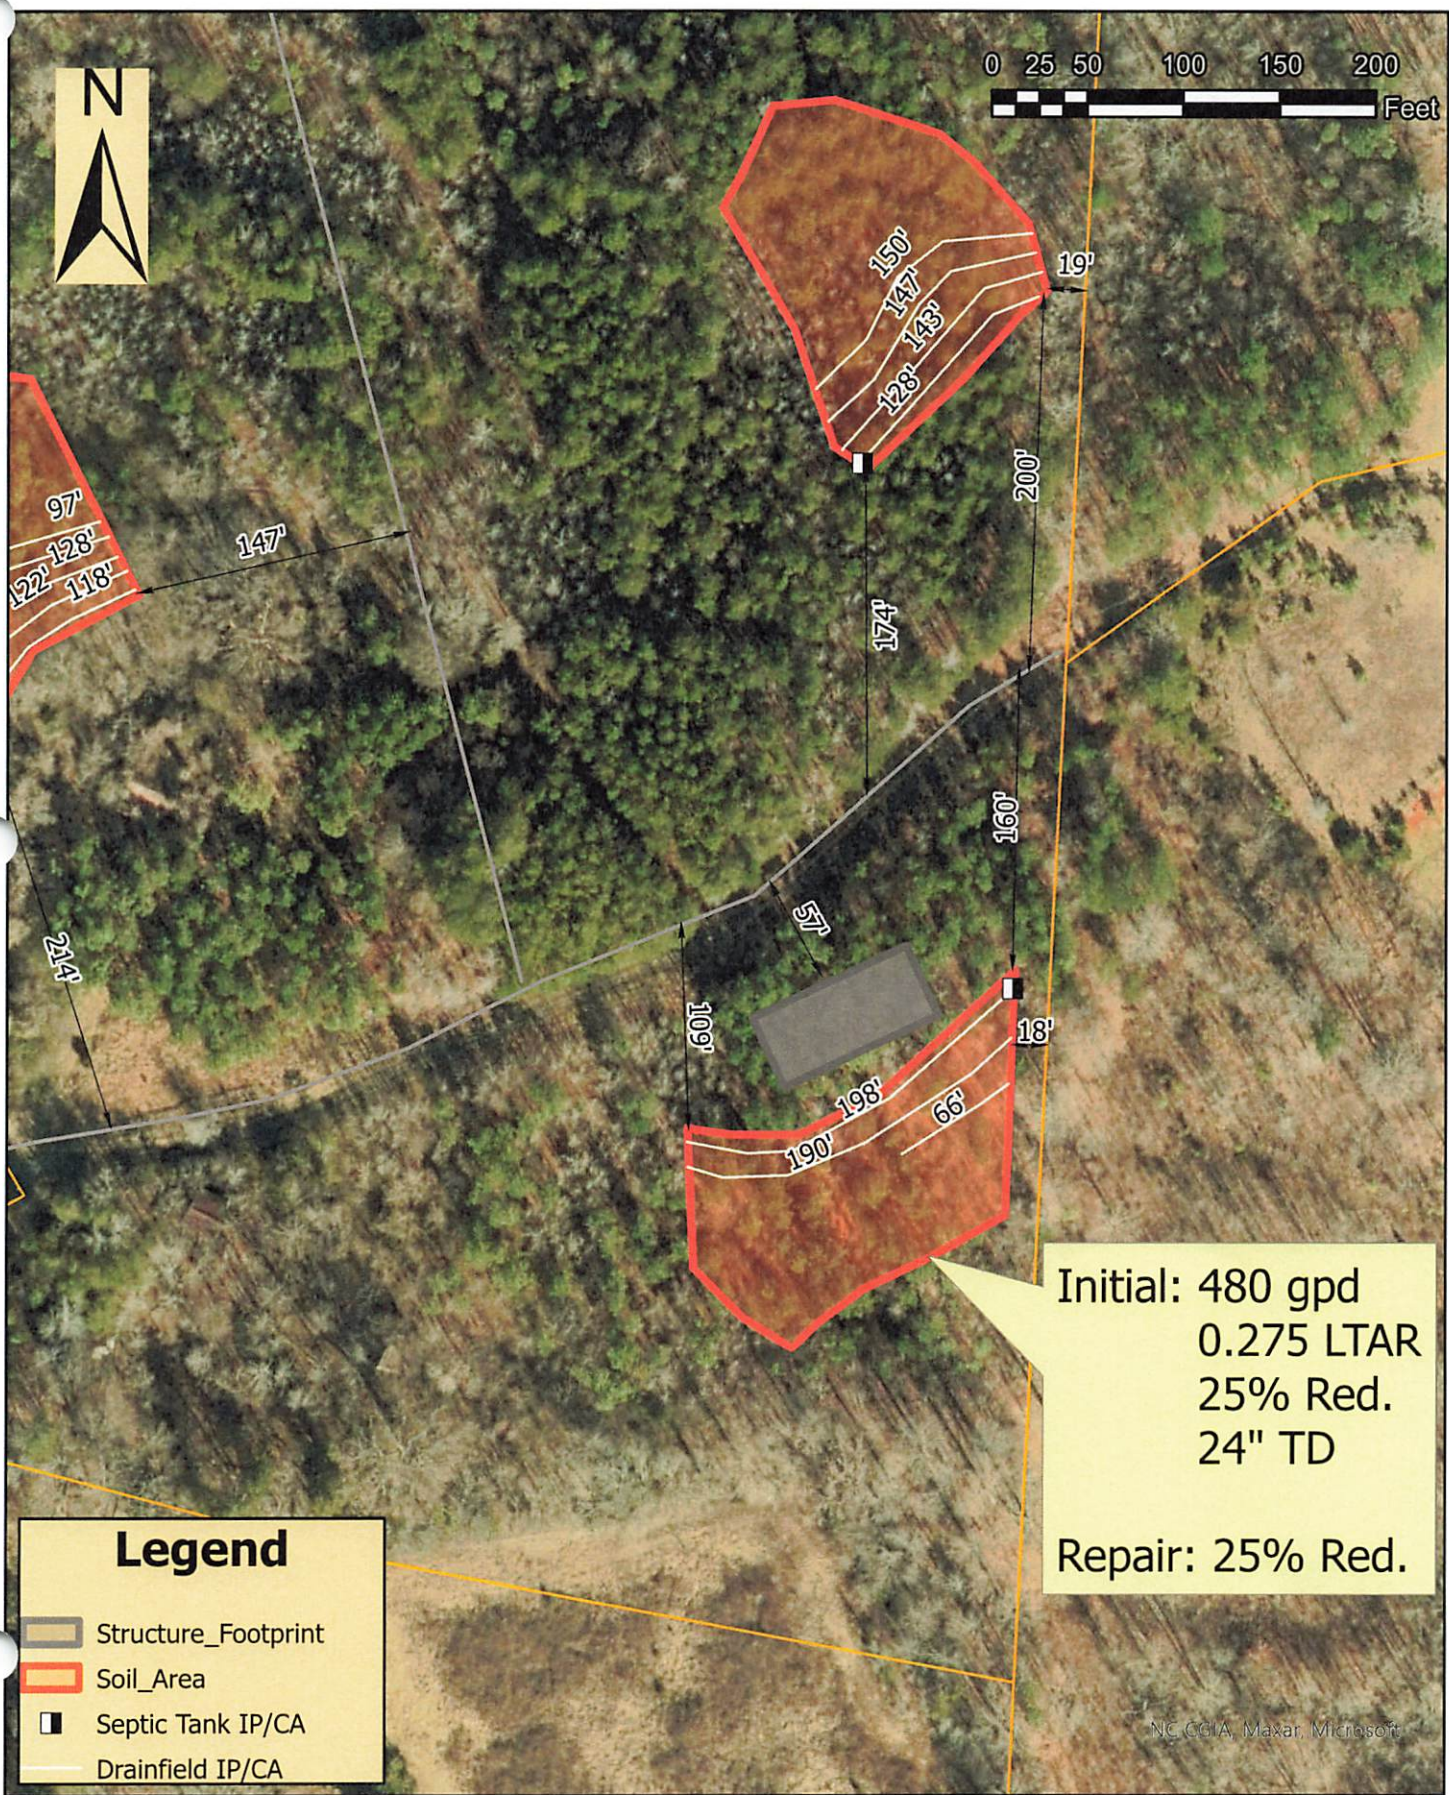

Initial: 480 gpd  
0.275 LTAR  
25% Red.  
24" TD

Repair: 25% Red.

**Legend**

- Structure\_Footprint
- Soil\_Area
- Septic Tank IP/CA
- Drainfield IP/CA